



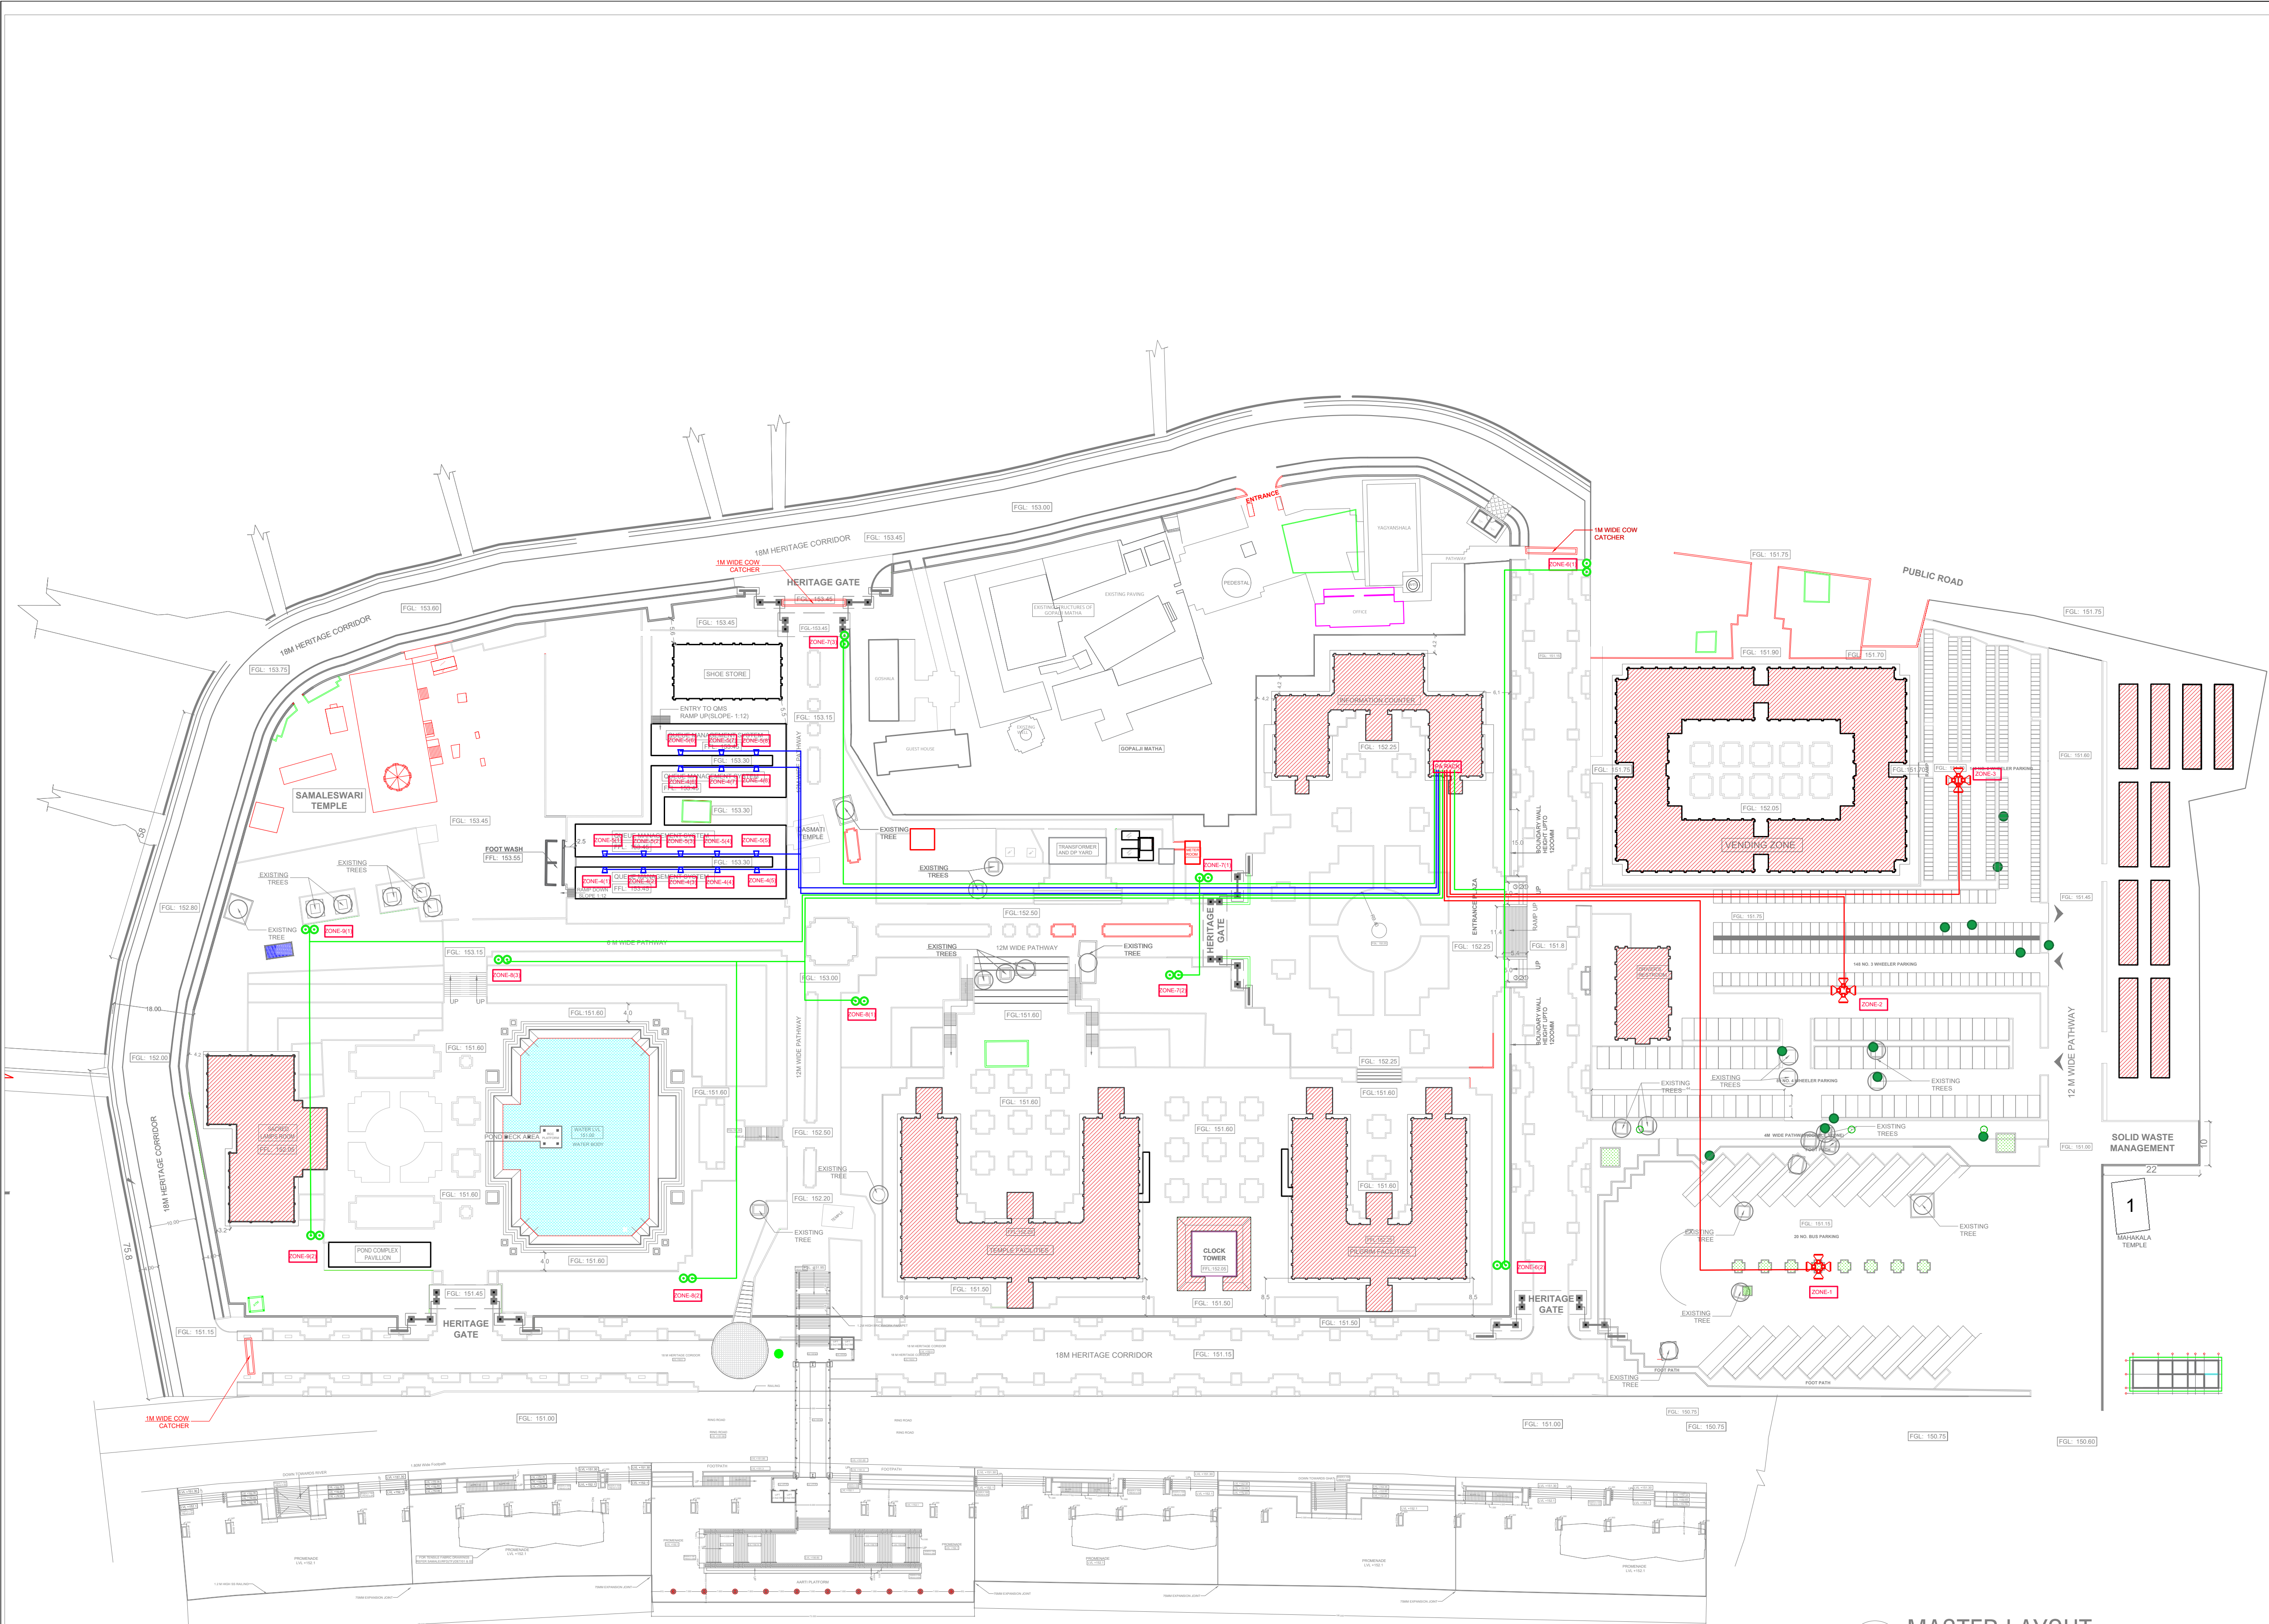

EXTERNAL PA SYSTEM LAYOUT

01 MASTER LAYOUT
WRITTEN DIMENSIONS TO BE FOLLOWED

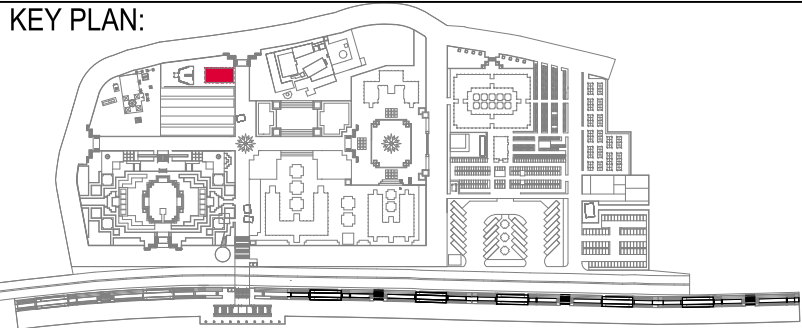

Symbol	Description
	Landscape Speaker(20Nos.)
	Indoor Speaker(16Nos.)
	Horn Speaker(12Nos.)

- GENERAL NOTES:
- ALL DIMENSIONS ARE IN MM UNLESS OTHERWISE SPECIFIED.
 - DO NOT SCALE THE DRAWING REFER TO DIMENSIONS AS INDICATED.
 - THIS DRAWING SHALL BE READ WITH RELEVANT ARCHITECTURAL AND STRUCTURAL DRAWING.

REVISION LIST				
DATE	REVISION	DESCRIPTION	CHECKED	APPROVED
21-01-2023	RO	FOR APPROVAL	Sourajit	VENKATESAN

CLIENT:

obcc Odisha Bridge & Construction Corporation Limited
Vikash Bhawan Nayapalli,
Bhubaneswar-12,
KURDA, ODISHA - 751012.

THIRD PARTY CONSULTANT

Space CUBE
ARCHITECTS, ENGINEERS, TOWN PLANNERS
485(D), KARGIL ROAD, BHIMPUR, BHUBANESWAR
ODISHA - 751020

CONTRACTOR:

URC URC CONSTRUCTION PVT.LTD
119, Power house road,
Erode , Tamilnadu,India 638 0001.
Ph.No:0424-2430138,2430139.

MEP CONSULTANT

CREATIVE TECHNOLOGY DESIGN CONSULTANCY PVT. LTD.
5201 KONARK APARTMENT, OPP. FALCON HOUSE
CUTTACK ROAD, LAXMISAGAR, BHUBANESWAR, ODISHA-751006
PHONE: +91-8280162000,

PROJECT TITLE:

REDEVELOPMENT FOR MAA SAMELESWARI
TEMPLE COMPLEX SAMBALPUR

DRAWING TITLE:

EXTERNAL PA SYSTEM LAYOUT-ASBUILT

DWG. NO:	OBCC-SAMALEI-ELV-EXT-PA-001		
DRAWN	Sourajit	REV.	RO
DESIGNED	Sourajit	SCALE	NTS @A1
CHECKED	Venkatesan	DATE	21/01/2023
APPROVED	Venkatesan	SHEET	1 OF 1